


APPENDIX A - Indicative CPO Boundary Plan- nb hatched blocks may be excluded at a later stage and other variations may be made

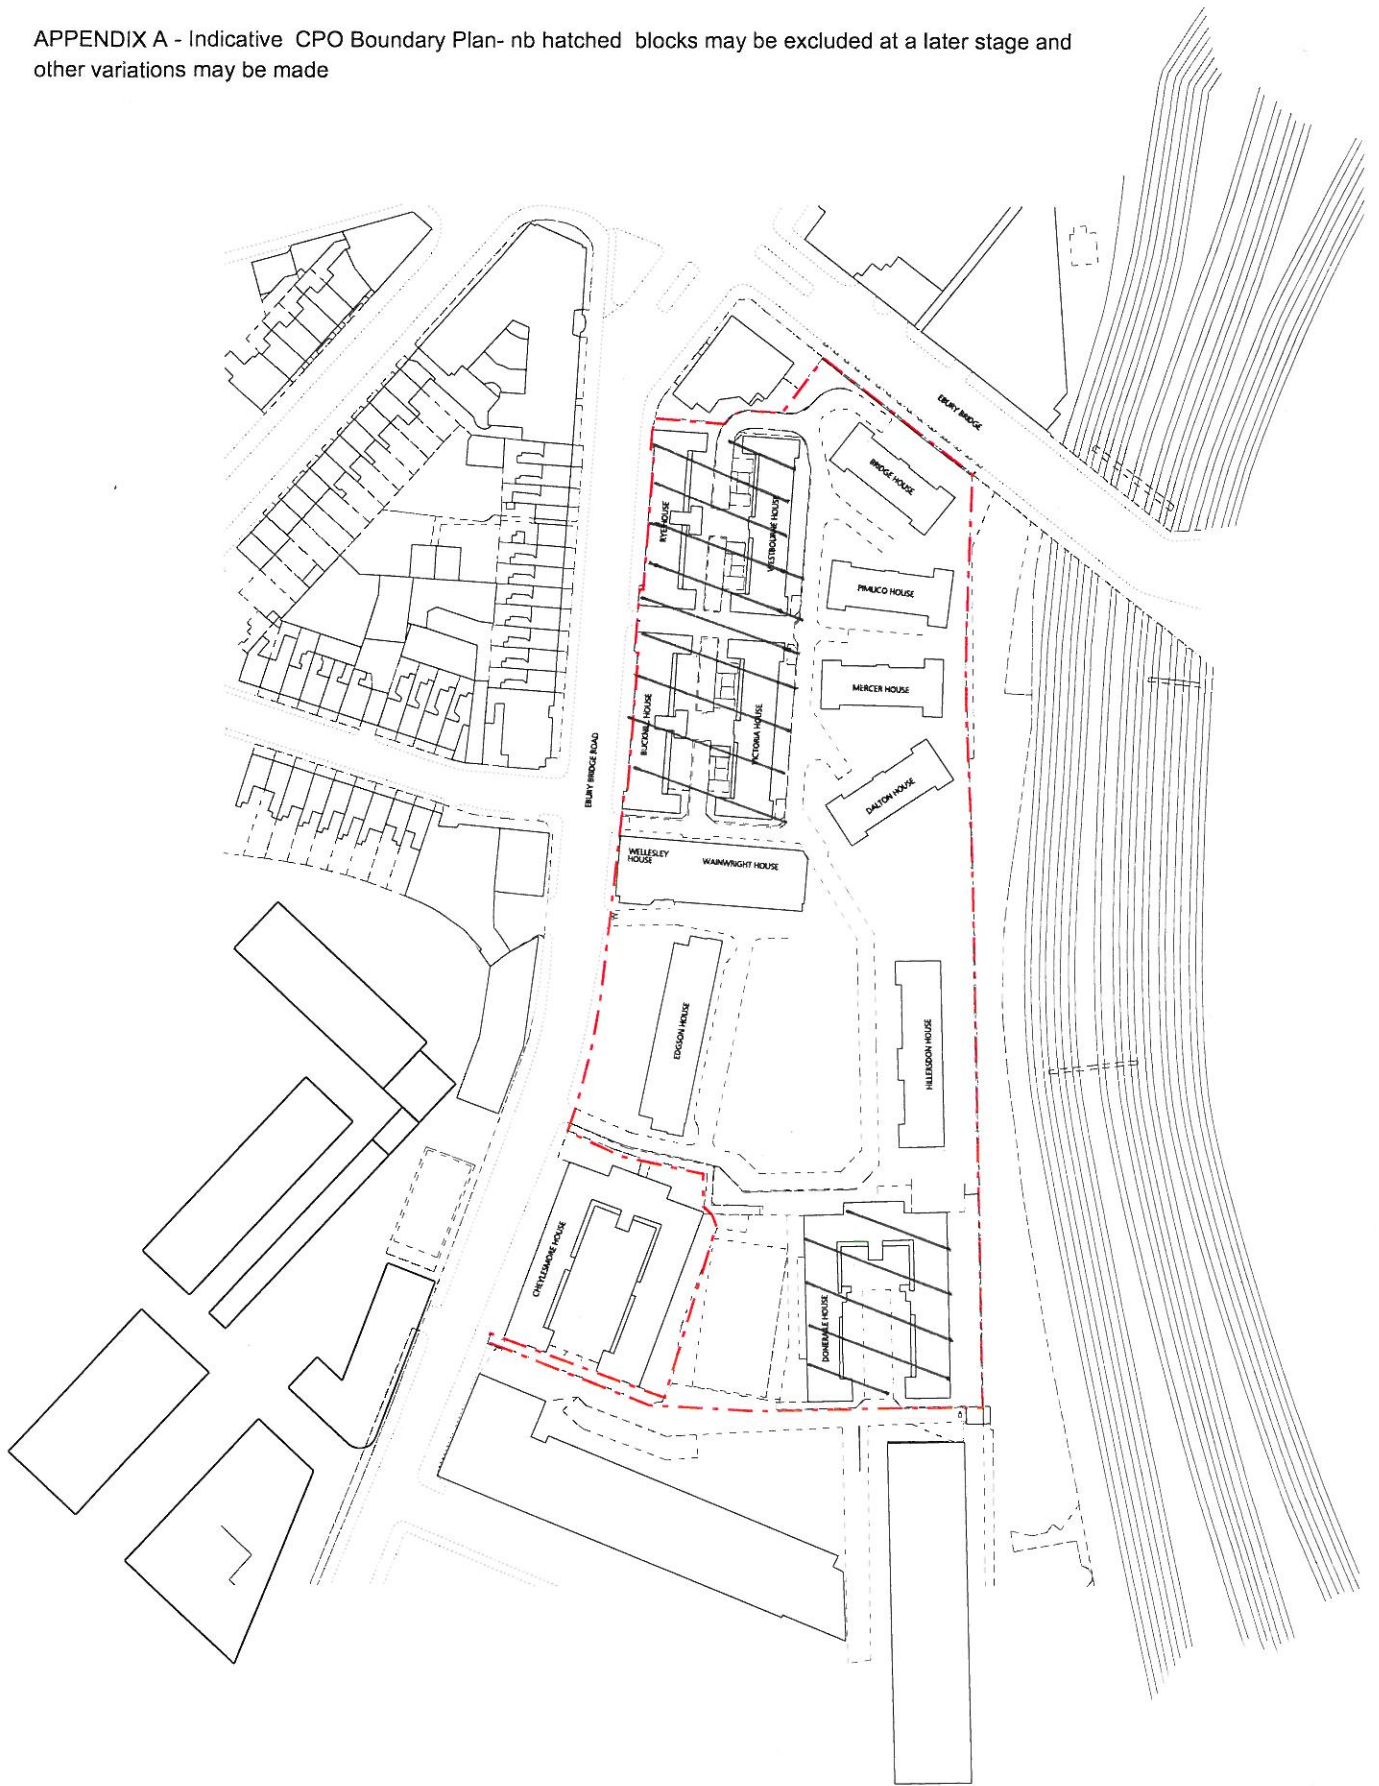

revision	date	drawn	description
-	28.01.14	LTD	For Planning

Location Plan (as existing)

CWH-EBE-AL-001

drawing title

drawing number

revision

client / job name

job reference

scale

drawn

**City of Westminster
Ebury Bridge Estate**



CWH-EBE

1:1250 @ A3

LTD

0m 25m 50m 75m 100m 125m

Do not scale from drawings unless by agreement with HTA. Use figured dimensions only. Check all dimensions on site prior to commencing the works. Drawing to be read in conjunction with other relevant consultant information. This drawing is the copyright of HTA Architects Ltd. and must not be copied or reproduced in part, or in whole, without the express permission of HTA Architects Ltd.



HTA, 106 - 110 Kentish Town Road, London UK NW1 9PX
P (020) 7485 8555 F (020) 7485 1232 info@hta.co.uk

FOR PLANNING